


SECTOR - C

STAMP OF APPROVAL OF PLANS

Plans approved vide letter No.MDC/ROT-1/ 3219 / 13 OCT 2017 Date :-

Dy. Planner M.I.D.C.Thane-1 Regional officer M.I.D.C.Thane-1

STAMP OF DATE OF RECEIPT OF PLANS

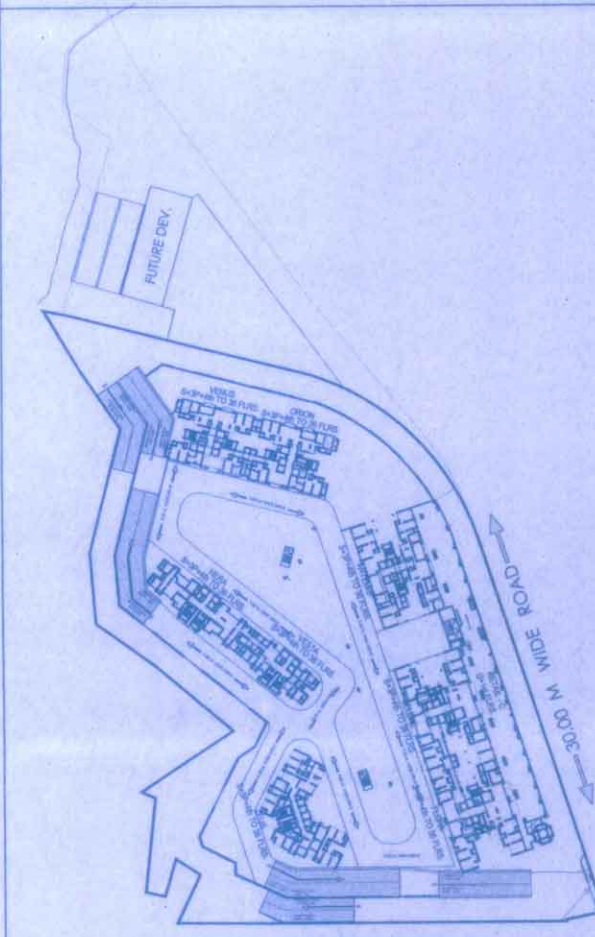

KEY PLAN

PROFORMA - B

CONTENTS OF SHEET

1) PLOT OPEN SPACES LAYOUT

For Persipina Developers Private Ltd

Authorised Signatory / Director

NAME & SIGNATURE OF OWNER

For Persipina Developers Private Limited

Mr. XERXES MISTRY AUTHORIZED SIGNATORY For M/s PERSIPINA DEVELOPERS PVT.LTD

M/s PERSIPINA DEVELOPERS PVT.LTD 'ALPHA' Building, 11th Floor, MAIN STREET, HIRANANDANI GARDENS POWAI,MUMBAI,400076, INDIA


DESCRIPTION OF PROPOSAL & PROPERTY

DRAWINGS / AS BUILT DRAWINGS FOR REVISED / AMENDED COPY RT / OC For 8 Residential Buildings (Viz Selene, Flora, Artemis, Venus, Orion, Hera, Vesta, Zeus) and Retail C - Convenience Shopping in notified SEZ 138.81 Ha. In Non-Processing Zone of Sector Specified SEZ for Services on Plot no 620 Part, 652 Part, 660, 670 Part & 680 Part at Village Bhokarpada (Taluka-Panvel) and Panhali and Talgaon (Taluka-Ahmednagar), District Raigad

JOB NO. _____ ORG. NO. _____ SCALE AS SHOWN DATE 16.09.2017 DRAWN BY JOSHIMAN G. CHOD BY GAURMEZ SINGH

ARCHITECT NAME & SIGNATURE

GUNISHA SETHI SANYAL CA/2014/6390 ADDRESS OF ARCHITECT DESIGN CENTRE 'OLYMPIA' Central Avenue Hiranandani Business Park, Powai, MUMBAI (Bombay) - 400076, India Tel: (91-22) 2576 3600 Fax : (91-22) 2570 5242 DRG. NO. 107/41

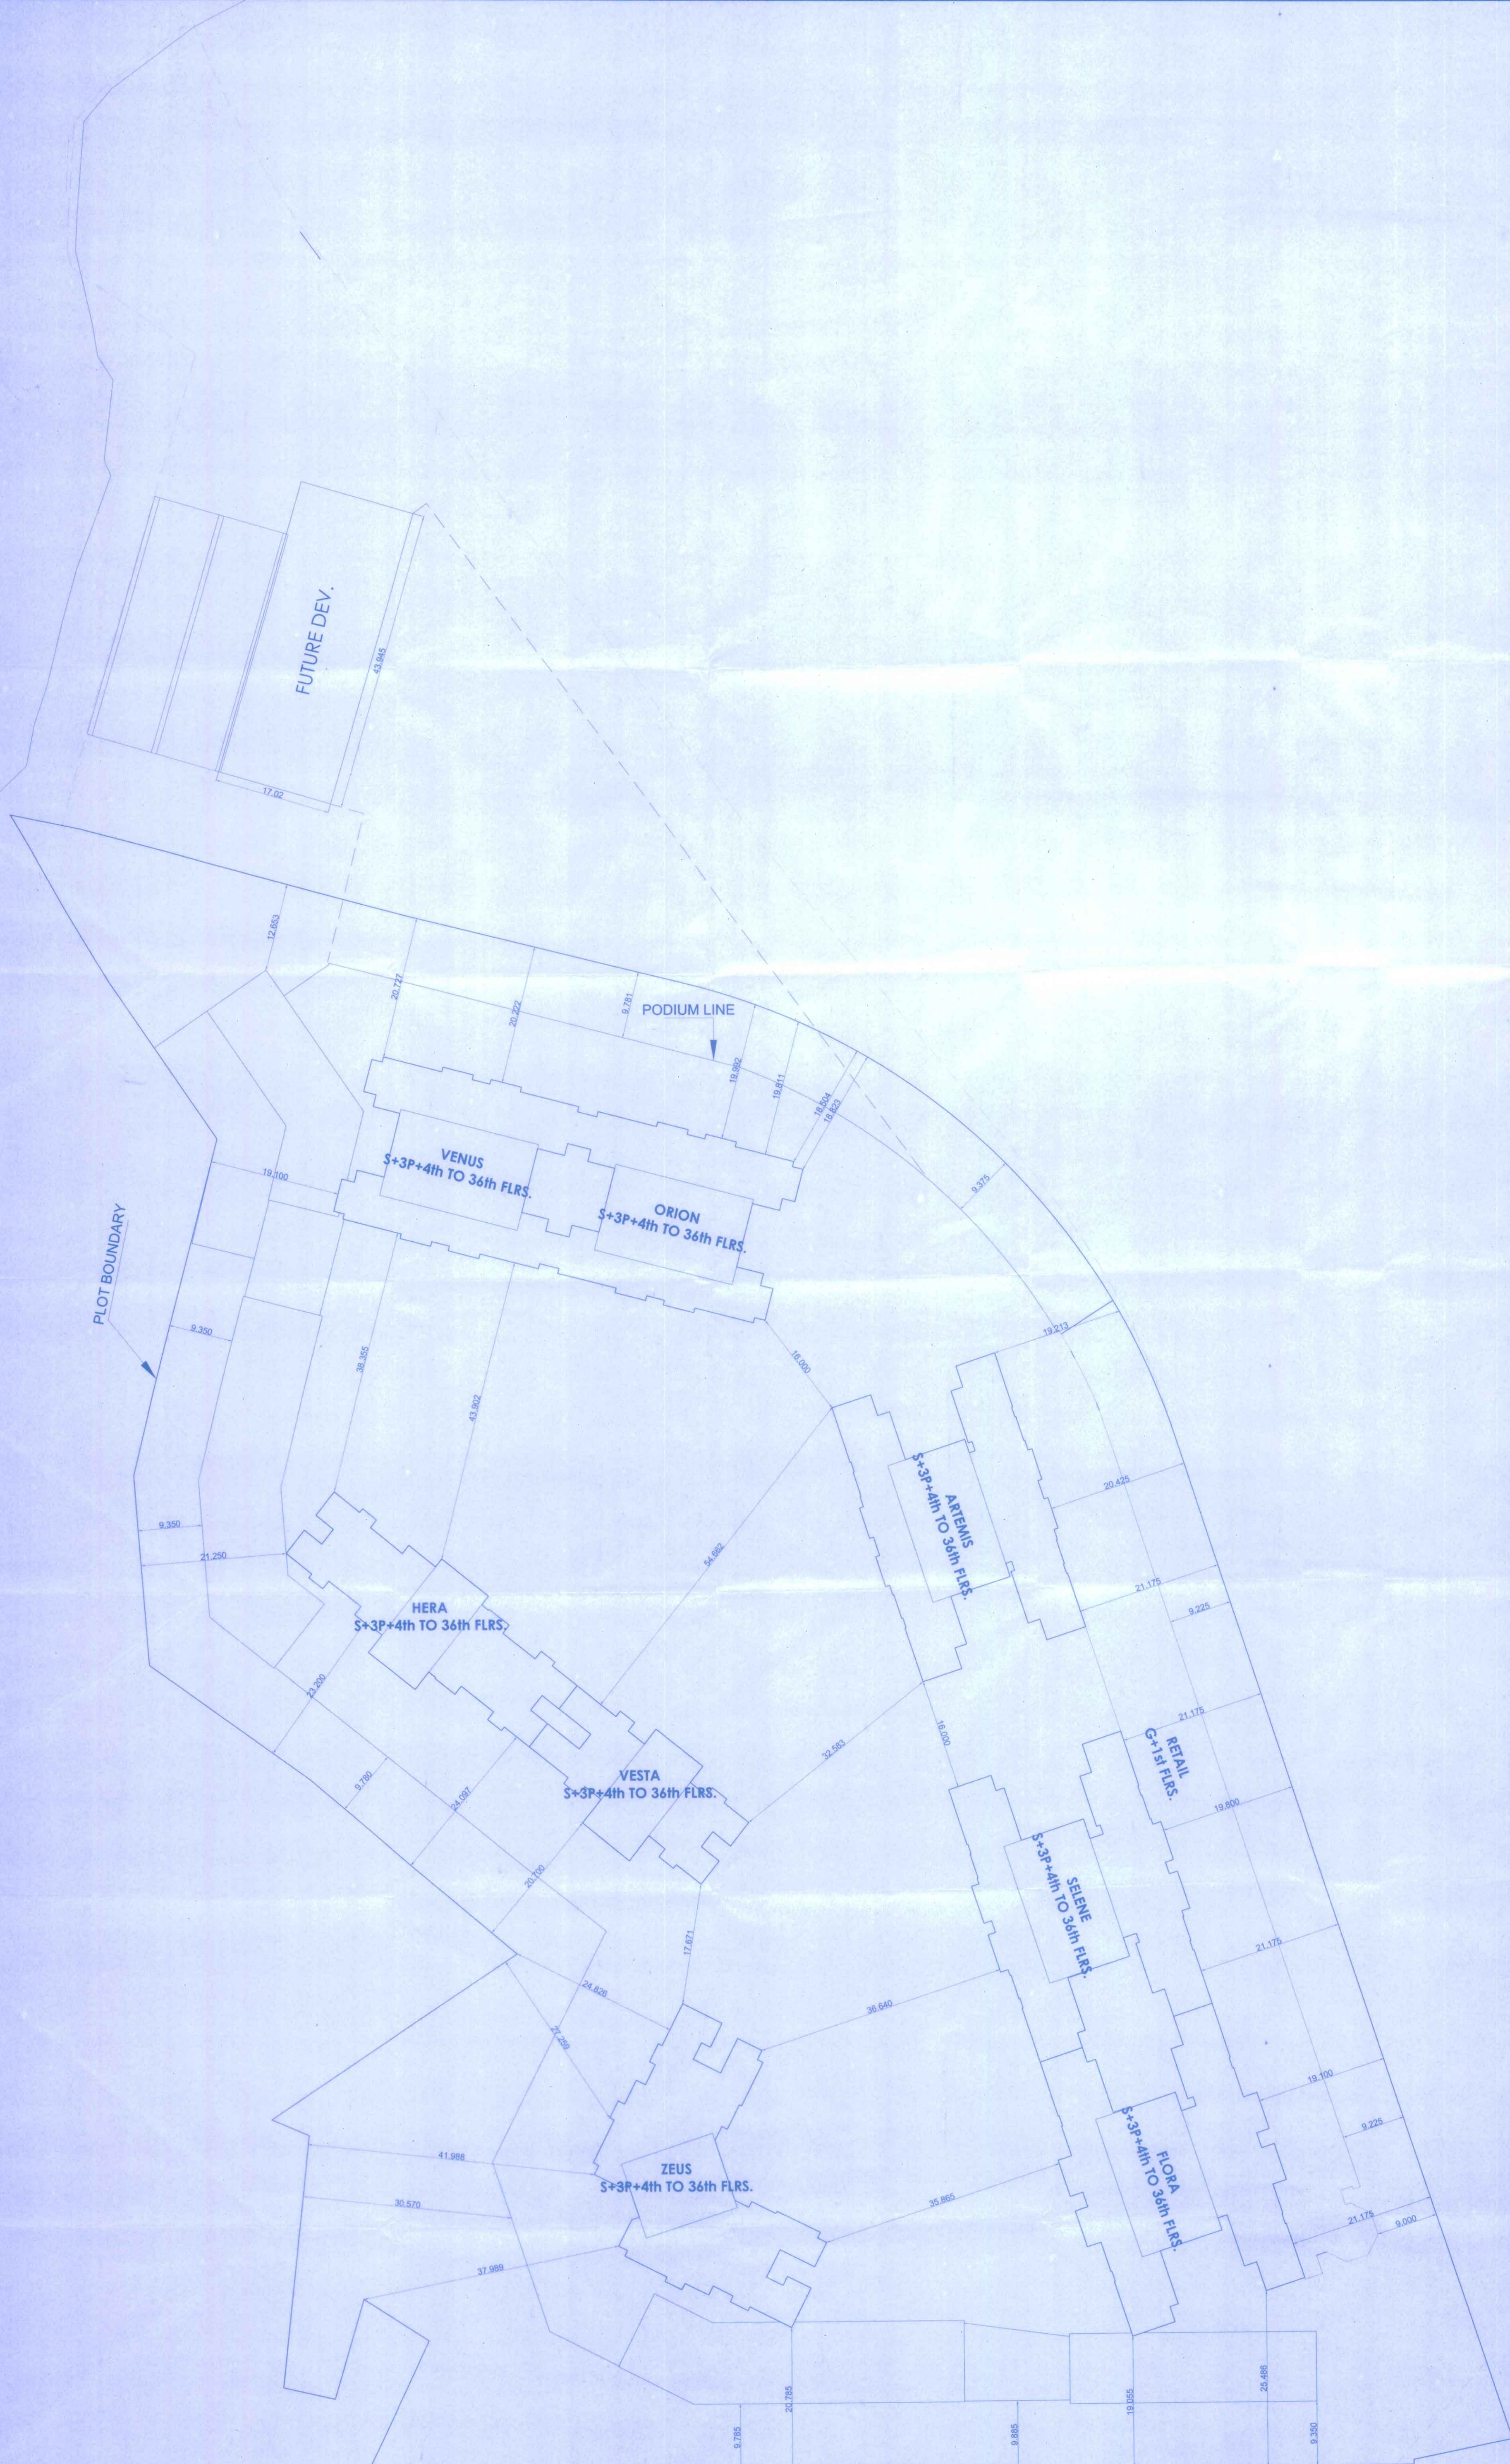

PLOT OPEN SPACES LAYOUT

SCALE - 1:300