


**मंजूरी**

मुंबई शहर महानगरपालिका  
 व संयुक्त नगरपालिका  
 २०/१६/२३४/२१/१६/२३४  
 सर्वे वास्तु विभाग

नगरपालिका  
 नगरपालिका  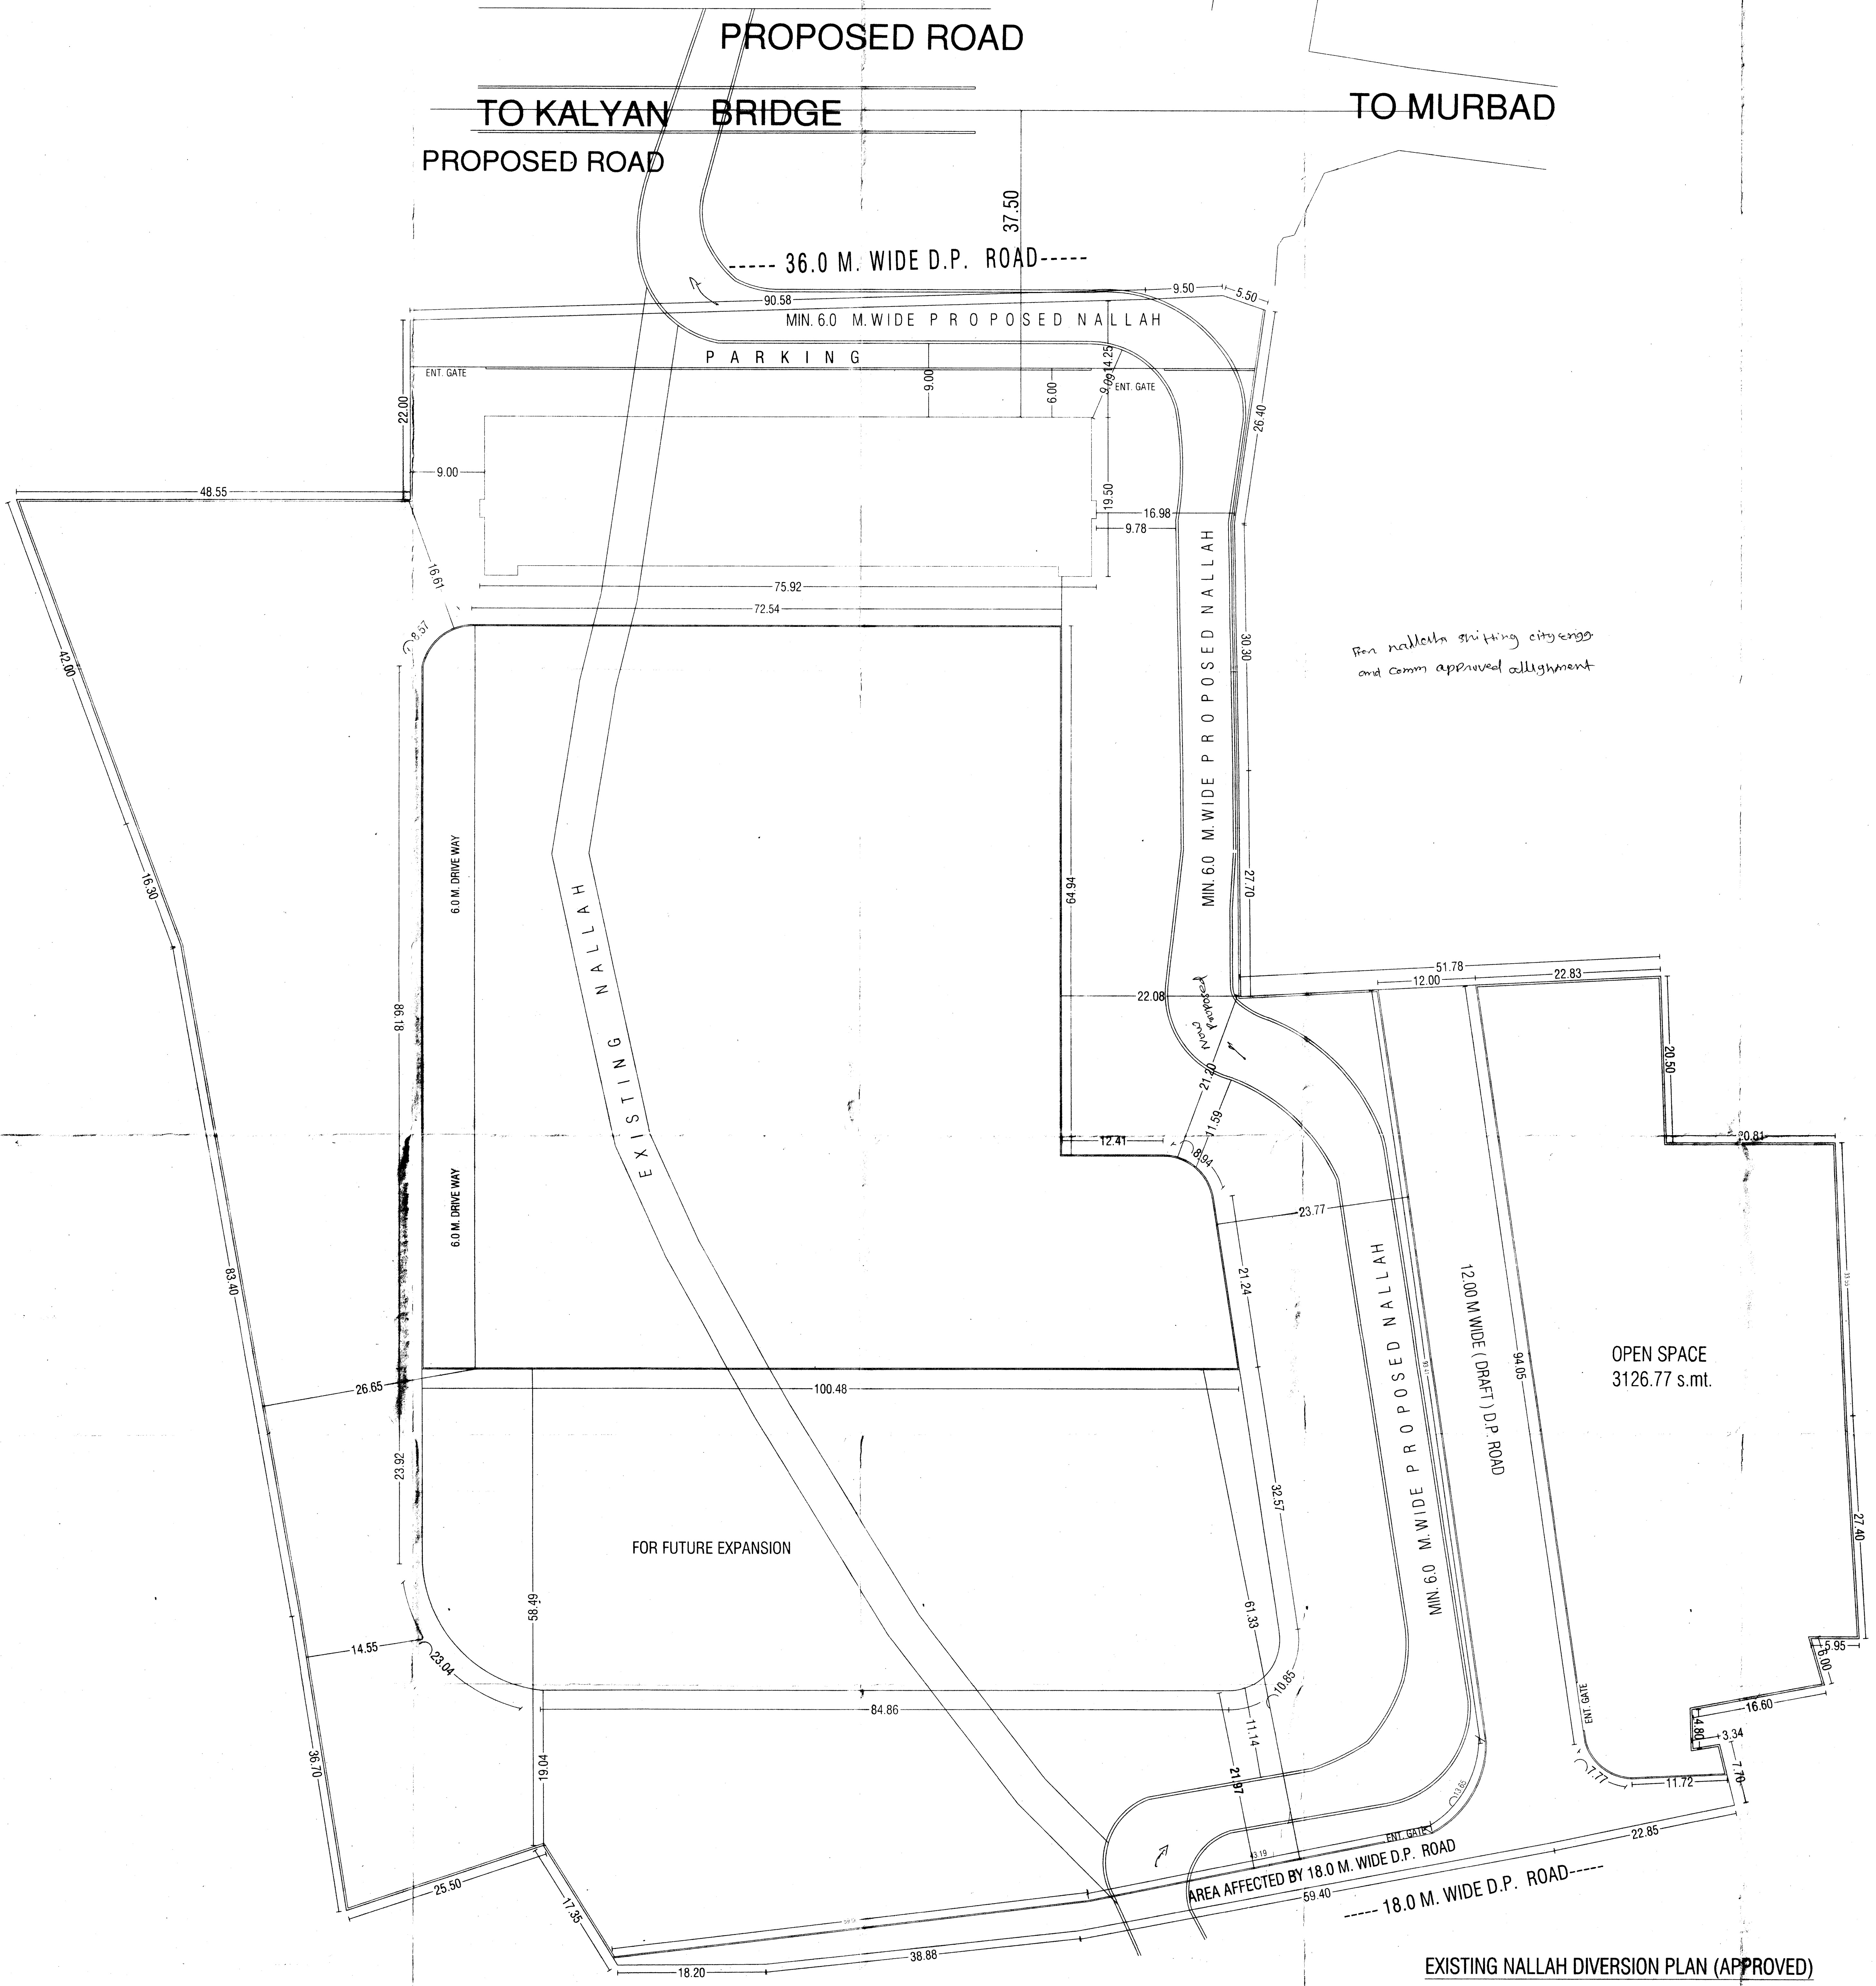
NOTES

- BOUNDARY OF PLOT BOUNDED THICK BLACK
- PROPOSED WORK SHOWN IN RED
- EXISTING BALCONY
- AREA UNDER SET BACK SHOWN IN DOTTED GREEN
- STRUCTURES TO BE DEMOLISHED SHOWN IN YELLOW
- RECREATION SHOWN IN GREEN WASH
- AREA UNDER PROPOSED ROAD SHOWN IN BLUE
- PROPOSED WORK
- URBAN USE

PROFORMA -- II  
 CONTENTS OF SHEET

EXISTING & PROPOSED NALLAH DIVERSION PLAN & CROSS SECTION THROUGH NALLAH  
 (SCALE 1:300) APPROVED.

NAME OF OWNER

M/S. ANUP HOSPITALITY SERVICES PVT. LTD.  
 THROUGH AUTHORIZED DIRECTOR MR. KUMAR U. AILANI

REVISION	DESCRIPTION	DATE	SIGNATURE

CERTIFICATE OF AREA

CERTIFIED THAT THE PLOT UNDER REFERENCE WAS SURVEYED BY ME ON AND THE DIMENSION OF THE SIDES ETC. OF THE STATED ON THE PLANS ARE AS MEASURED ON SITE AND THE AREA SO WORKED OUT TALLIES WITH THE AREA STATED IN THE DOCUMENTS OF OWNERSHIP / T.P. RECORD / LAND RECORDS DEPT. / CITY SURVEY RECORDS.

Engineer / Structural Engineer

DESCRIPTION OF PROPOSAL & PROPERTY

PROPOSED CONSTRUCTION ON PLOT NO. 6 ( P ), 7 & 8 ; SHEET NO. 92, 93 & 94 ; C. T. S. NO. 1618, 1619 A, 1625 & 1626 A  
 ULHASNAGAR - 1.

JOB No.	DATE	DRG. No.	SCALE	DRAWN BY	CHECKED BY
01/2019	10.12.2019	A.H.01/R1	AS GIVEN	ANAND-G	NAIR

CA/2017/86906

BHOJWANI TOWER - 201, 2ND FLOOR, OPPOSITE RAJU SOCIETY,  
 SECTION -17, ULHASNAGAR -3

EXISTING NALLAH DIVERSION PLAN (APPROVED)  
 SCALE = 1 : 300