BUILT UP AREA SUMMARY (AVENUE-A3(a))

TYPE	FLOOR	AREA IN SQMT.	No. OF BLDG.	TOTAL AREA	No. OF TENEMENTS
E03 WING-A,B,C	S/G+7	6289.31	01	6289.31	05 COMM. 134 RESI.
TOTAL				6289.31	

BUILT UP AREA SUMMARY (AVENUE-A3(b))

BLDG. NO.	FLOOR	AREA IN SQMT.	No. OF BLDG.	TOTAL AREA	No. OF TENEMENTS
E07 WING-A,B,C	S/G+7	6306.88 sqmt	01	6306.88	08 COMM. 135 RESI.
TOTAL			01	6306.88	08 COMM. 135 RESI.

BUILT UP AREA SUMMARY (AVENUE-A4)

BLDG. NO.	FLOOR	AREA IN SQMT.	No. OF BLDG.	TOTAL AREA	No. OF TENEMENTS
E01 1,2,3,4	G+7	7027.71 sqmt	01	7027.71	38 COMM. 134 RESI.
E02 5,6,7,8	G+7	7025.36 sqmt	01	[illegible]	09 COMM. 185 RESI.
TOTAL			02	14563.07	47 COMM. 319 RESI.

BUILT UP AREA SUMMARY (AVENUE-A6)

TYPE	FLOOR	AREA IN SQMT.	No. OF BLDG.	TOTAL AREA	No. OF TENEMENTS
E03 WING-A,B	S/G+7	3850.61 sqmt	01	3850.61 sqmt	14 SHOP 72 RESI.
E04 WING-C,D	S/G+7	4228.38 sqmt	01	4228.38 sqmt	88 RESI.
TOTAL			02	8078.99	14 SHOP 160 RESI.

BUILT UP AREA SUMMARY (AVENUE-B(2))

TYPE	FLOOR	AREA IN SQMT.	No. OF BLDG.	TOTAL AREA	No. OF TENEMENTS
A3,C&D	S/G+7	[illegible]	[illegible]	[illegible]	30 SHOP 180 RESI.
B1&B1A	S/G+7	2187.81	01	2187.81	57 RESI.
BAB2	S/G+7	2063.47	01	2063.64	54 RESI.
C&B	S/G+7	2252.75	01	2252.75	57 RESI.
C1&B1	S/G+7	2130.76	01	2130.76	54 RESI.
TOTAL			06	17941.86	50 SHOP 420 RESI.

BUILT UP AREA SUMMARY (AVENUE-C1)

TYPE	FLOOR	AREA IN SQMT.	No. OF BLDG.	TOTAL AREA	No. OF TENEMENTS
PG1	G+7	3444.08	01	3444.08	14 COMM. 72 RESI.
TOTAL			01	3444.08	14 COMM. 72 RESI.

BUILT UP AREA SUMMARY (AVENUE-C2)

TYPE	FLOOR	AREA IN SQMT.	No. OF BLDG.	TOTAL AREA	No. OF TENEMENTS
YC1 3,4	S/G+7	3443.39	01	3443.39	12 SHOP 60 RESI.
TOTAL			01	3443.39	12 SHOP 60 RESI.

BUILT UP AREA SUMMARY (AVENUE-C3)

TYPE	FLOOR	AREA IN SQMT.	No. OF BLDG.	TOTAL AREA	No. OF TENEMENTS
AG1 WING-A,B,C,D,E	S/G+7	8173.52	01	8173.52	43 COMM. 150 RESI.
TOTAL			01	8173.52	43 COMM. 150 RESI.

BUILT UP AREA SUMMARY (AVENUE-D)

TYPE	FLOOR	AREA IN SQMT.	No. OF BLDG.	TOTAL AREA	No. OF TENEMENTS
RD 24,25,26,27,28	S/G+7	1911.27	05	9556.35	235 RESI.
TD1 1,3,4	S/G+7	1567.00	03	4701.00	12 SHOP 87 RESI.
TD2 12,20	S/G+7	2405.97	02	4811.94	12 SHOP 90 RESI.
TD3A 5,17,22	S/G+7	2409.86	03	7229.58	15 SHOP 94 RESI.
TD6 2	S/G+7	2392.03	01	2392.03	08 SHOP 58 RESI.
TD3 15	S/G+7	2425.29	01	2425.29	10 SHOP 43 RESI.
TD4 8,10	S/G+7	2340.75	02	4681.50	94 RESI.
TD 6,7,19,23	S/G+7	1542.29	04	6169.16	124 RESI.
XD1 16	S/G+7	2278.04	01	2278.04	08 SHOP 29 RESI.
XD 11	S/G+7	2263.80	01	2263.80	31 RESI.
YD2 14	S/G+7	1918.16	01	1918.16	11 SHOP 29 RESI.
YD1 13,21	S/G+7	1821.73	02	3643.46	12 SHOP 68 RESI.
YD 9,18	S/G+7	1805.41	02	3610.82	62 RESI.
RD 20	S/G+7	1891.07	01	1891.07	47 RESI.
RD1 36	S/G+7	1891.07	01	1891.07	47 RESI.
TE1 38,40	S/G+7	1532.39	02	3064.78	08 SHOP 58 RESI.
TD2 30,37	S/G+7	2355.73	02	4711.46	12 SHOP 90 RESI.
TD6 39	S/G+7	2240.54	01	2240.54	10 SHOP 41 RESI.
TD 31,32,33,34	S/G+7	1506.45	04	6025.80	124 RESI.
YD1 29	S/G+7	1783.55	01	1783.55	06 SHOP 29 RESI.
TOTAL			40	77280.20	127 SHOP 1488 RESI.

BUILT UP AREA SUMMARY (AVENUE-F1&F2)

WING	FLOOR	AREA IN SQMT.	No. OF BLDG.	TOTAL AREA	No. OF TENEMENTS
MG2 WING-C&D	S/G+7	5329.06	01	5329.06	22 COMM. 112 RESI.
MG3 WING-E&F	S/G+7	5437.19	01	5437.19	120 RESI.
MG1 WING-A&B	S/G+7	5473.18	01	5473.18	19 COMM. 02 OFFICE 109 RESI.
MG4 WING-G	S/G+7	2444.40	01	2444.40	60 RESI.
MG4 WING-H	S/G+7	2402.32	01	2402.32	11 RESI.
TOTAL			05	21086.15	41 COMM. 02 OFFICE 459 RESI.

BUILT UP AREA SUMMARY (AVENUE-G)

TYPE	FLOOR	AREA IN SQMT.	No. OF BLDG.	TOTAL AREA	No. OF TENEMENTS
R1 1,4,6,7,8,9,10	S/G+7	[illegible]	06	[illegible]	240 RESI.
R2 12,13,14,15,16	S/G+7	[illegible]	05	[illegible]	38 SHOP 168 RESI.
R4 11	S/G+7	1724.37	[illegible]	1724.37	SHOP
TOTAL			15	[illegible]	41 [illegible] 432 RESI.

BUILT UP AREA SUMMARY (AVENUE-H)

TYPE	FLOOR	AREA IN SQM.	No. OF BLDG.	TOTAL AREA	No. OF TENEMENTS
T1 [illegible]	S/G+7	1701.01	17	28917.17	119 SHOP 476 RESI.
V4 15	S/G+7	[illegible]	01	[illegible]	14 SHOP 42 RESI.
S1 [illegible]	S/G+7	1148.40	11	12632.40	330 RESI.
S3 [illegible]	S/G+7	[illegible]	09	10616.78	30 SHOP 30 RESI.
T1 10,11,13,14,16	S/G+7	1489.32	05	7446.60	25 SHOP 140 RESI.
TOTAL			43	62180.93	184 SHOP 1240 RESI.

BUILT UP AREA SUMMARY (AVENUE-J)

TYPE	FLOOR	AREA IN SQMT.	No. OF BLDG.	TOTAL AREA	No. OF TENEMENTS
Y1 10,11,12,14,15,16,17,18,19,20,22,23,24,25,26,27,28,34,35	S/G+7	1701.01	19	32319.19	133 SHOP 532 RESI.
Y2 21	S/G+7	3109.87	01	3109.87	11 SHOP 49 RESI.
R1 41,42,43,44,54,55,56	S/G+7	1049.56	07	7346.92	210 RESI.
R2 53,57	S/G+7	1053.67	02	2107.34	60 RESI.
S1 37,38,39,40,58,59,60,61,62,63	S/G+7	1148.40	10	11484.00	300 RESI.
S3-64	S/G+7	1155.70	01	1155.70	30 RESI.
T1 1,2,3,5,6,7,8,29,30,31,32,33,36	S/G+7	1489.32	13	19361.16	62 SHOP 572 RESI.
T2-4	S/G+7	2379.11	01	2379.11	09 SHOP 42 RESI.
T3-9	S/G+7	2285.86	01	2285.86	09 SHOP 42 RESI.
T5 45,46,47,50,51,52	S/G+7	1464.70	06	8788.20	180 RESI.
T6 48,49	S/G+7	1489.59	02	2979.18	60 RESI.
TOTAL			63	93316.53	214 SHOP 2047 RESI.

BUILT UP AREA SUMMARY (AVENUE-M.)

TYPE	FLOOR	AREA IN SQMT.	No. OF BLDG.	TOTAL AREA	No. OF TENEMENTS
U1 10,11	S/G+7	1770.10	02	3540.20	14 SHOP 56 RESI.
U2-15	S/G+7	1575.09	01	1575.09	13 SHOP 21 RESI.
UB3	S/G+7	1911.35	01	1911.35	15 SHOP 28 RESI.
W1 5,6	S/G+7	1666.36	02	3332.72	10 SHOP 28 RESI.
X1 1,2,3,[illegible]	S/G+7	1955.69	08	15645.52	56 SHOP 224 RESI.
X1 18,19,20	S/G+7	1924.41	03	5773.23	90 RESI.
V1 4,5,7	S/G+7	2438.43	03	7315.29	30 SHOP 84 RESI.
TOTAL			20	39093.40	138 SHOP 531 RESI.

BUILT UP AREA SUMMARY (AVENUE-I.)

TYPE	FLOOR	AREA IN SQ MT	No OF BLDG	TOTAL BLDG	No OF TENEMENT	No OF SHOP
YI [illegible]	S/G 14+7TH	2813.22	7	19692.54	378	28
RBI [illegible]	S/G 14+7TH	4164.48	6	24986.88	660	8
TKI 2	S/G 14+7TH	2065.18	1	2065.18	54	14
YI [illegible]	S/G 14+7TH	3108.16	10	31081.60	540	80
[illegible]	S/G 14+7TH	2256.44	1	2256.44	40	7
TOTAL			25	82982.64	1672	158

BUILT UP AREA SUMMARY (AVENUE-K.)1

TYPE	FLOOR	AREA IN SQ MT	No OF BLDG	TOTAL BLDG	No OF TENEMENT	No OF SHOP
RK-3,5,1	S/G 14+7TH	2263.75	2	4527.50	108	8
YK-4	S/G 14+7TH	3198.72	1	3198.72	54	6
YK-1,7,2	S/G 14+7TH	3059.48	2	6118.96	108	0
TK-2,4	S/G 14+7TH	3443.54	1	3443.54	68	0
TK-6	S/G 14+7TH	[illegible]	1	[illegible]	54	4
TOTAL			07	20155.35	392	18

BUILT UP AREA SUMMARY (AVENUE-K.)2

TYPE	FLOOR	AREA IN SQ MT	No OF BLDG	TOTAL BLDG	No OF TENEMENT	No OF SHOP
RK-10,11,1	S/G 14+7TH	2263.75	2	4527.50	108	8
YK-8,13,2	S/G 14+7TH	3059.48	2	6118.96	108	0
TK-12,3	S/G 14+7TH	3569.49	1	3569.49	68	4
TK-9,6	S/G 14+7TH	3571.59	1	3571.59	68	4
TOTAL			06	17787.54	352	16

BUILT UP AREA SUMMARY (AVENUE-F3)

TYPE	FLOOR	AREA IN SQMT.	No. OF BLDG.	TOTAL AREA	No. OF TENEMENTS
GF	G+2	1794.33	01	1794.33	76 SHOP
TOTAL			01	1794.33	76 SHOP

BUILT UP AREA SUMMARY (AVENUE-L)

TYPE	FLOOR	AREA IN SQ MT	No OF BLDG	TOTAL BLDG	No OF TENEMENT	No OF SHOP
RL-1,23,24,1 31,25,30	S/G 14+7TH	[illegible]	6	[illegible]	324	24
[illegible]	S/G 14+7TH	[illegible]	11	[illegible]	594	66
[illegible]	S/G 14+7TH	[illegible]	[illegible]	[illegible]	[illegible]	[illegible]
TOTAL			30	[illegible]	2192	182

BUILT UP AREA SUMMARY (AVENUE-A1)

TYPE	FLOOR	AREA IN SQMT.	No. OF BLDG.	TOTAL AREA	No. OF TENEMENTS
RSA1 8	S/G+7	2337.20	01	2337.20	62 RESI.
RSA2 9	S/G+7	2344.65	01	2344.65	62 RESI.
TOTAL			02	4681.85	124 RESI.

BUILT UP AREA SUMMARY (AVENUE-A2)

TYPE	FLOOR	AREA IN SQMT.	No. OF BLDG.	TOTAL AREA	No. OF TENEMENTS
RSA1 7,8	S/G+7	2337.20	02	4674.40	124 RESI.
RSA2 9	S/G+7	2344.65	01	2344.65	62 RESI.
TOTAL			03	7019.05	186 RESI.

BUILT UP AREA SUMMARY (AVENUE-A5)

TYPE	FLOOR	AREA IN SQMT.	No. OF BLDG.	TOTAL AREA	No. OF TENEMENTS
YA1 WING-A,B,L	S/G+7	3766.25	01	3766.25	13 SHOP 91 RESI.
YA3 WING-C,D,E 25	S/G+7	3766.25	01	3766.25	13 SHOP 91 RESI.
YA4 WING-F,G,H 23	S/G+7	3439.92	01	3439.92	89 RESI.
YA2 WING-I,J,K 24	S/G+7	3439.92	01	3439.92	89 RESI.
	TOTAL	14412.34	04	14412.34	26 SHOP 360 RESI.

BUILT UP AREA SUMMARY (AVENUE-B (1))

TYPE	FLOOR	AREA IN SQMT.	No. OF BLDG.	TOTAL AREA	No. OF TENEMENTS
AB1 1,7	S/G+7	1365.06	02	2730.12	14 SHOP 56 RESI.
AB4 2,8	S/G+7	2179.67	02	4359.34	18 SHOP 84 RESI.
AB2 3	S+7	1249.62	01	1249.62	28 RESI.
A1 4,5	S+7	1070.60	02	2141.20	56 RESI.
CB1 6,17	S+7	1677.98	02	3355.96	56 RESI.
R7 9,16	S/G+7	2379.41	02	4758.82	18 SHOP 84 RESI.
A2 10,15	S/G+7	1157.18	02	2314.36	12 SHOP 56 RESI.
AB3 11,14	S/G+7	2246.33	02	4492.66	32 SHOP 84 RESI.
CB2 12,13	S/G+7	1843.55	02	3687.10	16 SHOP 56 RESI.
TOTAL			17	29097.18	110 SHOP 560 RESI.

BUILT UP AREA SUMMARY (AVENUE-K3)

TYPE	FLOOR	AREA IN SQMT.	No. OF BLDG.	TOTAL AREA	No. OF TENEMENTS
K7	S/G+14	3107.23	01	3107.23	76 RESI.
K7a	S/G+14	3316.81	01	3316.81	03 SHOP 76 RESI.
K8	S/G+14	3381.25	01	3381.25	03 SHOP 78 RESI.
K9	S/G+14	4966.50	01	4966.50	10 SHOP 86 RESI.
K10	S/G+14	4025.27	01	4025.27	06 SHOP 78 RESI.
TOTAL			5	18797.06	22 SHOP 394 RESI.

BUILT UP AREA SUMMARY (AVENUE-K4)

TYPE	FLOOR	AREA IN SQMT.	No. OF BLDG.	TOTAL AREA	No. OF TENEMENTS
K4	S/G+14	3892.37	01	3892.37	76 RESI.
K4A	S/G+14	3983.10	01	3983.10	02 SHOP 78 RESI.
K5	S/G+14	3538.47	01	3538.47	04 SHOP 78 RESI.
K5A	S/G+14	3604.96	01	3604.96	07 SHOP 78 RESI.
K6	S/G+14	2114.88	01	2114.88	05 SHOP 50 RESI.
TOTAL			5	17133.78	18 SHOP 358 RESI.

TOTAL PREVIOUSLY APPROVED AREA STATEMENT.

TYPE	FLOOR	AREA IN SQMT.	No. OF BLDG.	TOTAL AREA	No. OF TENEMENTS
TOTAL			314	707801.49	1381 SHOP 02 OFFICE 14267 RESI.

PARKING AREA STATEMENT

FLAT AREA	FLAT	FLAT REQUIRED SCOOTER	FLAT REQUIRED CAR	PROVIDED SCOOTER	PROVIDED CAR
25 TO 37.50sqm	171	NIL	NIL	NIL	NIL
25 TO 50sqm [illegible]	56	45	07	45	07
[illegible]	[illegible]	24	[illegible]	[illegible]	[illegible]
TOTAL [illegible]		69	[illegible]	70	[illegible]

PREVIOUSLY APPROVED AREA STATEMENT.

BUILT UP AREA SUMMARY (AVENUE-E)

TYPE	FLOOR	AREA IN SQMT	No. OF BLDG	TOTAL AREA	No. OF TENEMENTS
E01 WING-A,B	S/G+7	3472.93	01	3472.93	22 COMM. 70 RESI.
E02 WING-C,D,E	S/G+7	4696.30	01	4696.30	28 COMM. 98 RESI.
TOTAL			02	8169.23	50 COMM. 168 RESI.

NOW PROPOSED AREA STATEMENT.

BUILT UP AREA SUMMARY (AVENUE-E)

TYPE	FLOOR	AREA IN SQMT	No. OF BLDG	TOTAL AREA	No. OF TENEMENTS
E01 WING-A,B	S/G+7	3472.93	01	3472.93	22 COMM. 70 RESI.
E02 WING-C,D,E	S/G+7	4696.30	01	4696.30	28 COMM. 98 RESI.
TOTAL			02	8169.23	50 COMM. 168 RESI.

TOTAL AREA STATEMENT.

		No. OF BLDG.	TOTAL AREA	No. OF TENEMENTS
TOTAL AREA (PREVIOUSLY APPROVED + NOW PROPOSED)	(707801.49 + 8169.23)	316	715970.72	1431 SHOP 02 OFFICE 14435 RESI.

C.F.C. AREA STATEMENT

C.F.C. No	AREA IN SQMT
01	7161.00
02	437.00
03	2009.00
04	8049.00
05	2646.00
06	565.00
07	11501.00
08	1471.00
09	2150.00
TOTAL	33489.00

TOTAL C.F.C. AREA = 33489.00 sqm.

FORM I

	AREA STATEMENT	SQ. MTS.
1	AREA OF PLOT	93240.00
a	AREA DELETED FROM LAYOUT (8270+3630+1460+560+3269.07)	16909.07
b	AREA ACQUIRED BY P.W.D.	5960.00
2	NET AREA (1-(a+b))	879580.93
3	LESS PROPOSED 30M & 20M D.P. ROAD	126654.40
4	LESS D.P. RESERVATION	85148.83
5	TOTAL AREA (3+4)	211803.23
6	BALANCE AREA (2-5)	667477.70
7	15% F.C. OF 6	100121.66
8	5% C.F.C. OF 6	33373.89
9	NET AREA (6-7-8)	567356.04
10	ADD 1.5% LAND POCKING AREA (6)	53898.82
11	ADD 75% D.P. ROAD AREA	94990.80
12	PERMISSIBLE BUILT UP AREA	716245.66
13	PREVIOUSLY APPROVED AREA	707801.49
14	NOW PROPOSED AREA	8169.23
15	TOTAL BUILT UP AREA PROPOSED	715970.72
16	BALANCE AREA	274.94
C	TENEMENT STATEMENT	
	(i) PROPOSED AREA (ITEM 14ABOVE)	8169.23
	(ii) LESS DEDUCTION NON-RESIDENTIAL AREA (SHOP Etc)	869.70
	(iii) AREA AVAILABLE FOR TENEMENTS (i) MINUS (ii)	7299.53
	(iv) TENEMENTS PERMISSIBLE (DENSITY OF TENEMENTS/HECTARE)	224
	(v) TENEMENTS PROPOSED(RESI. FLATS)	168
	(vi) NO OF SHOPS PROPOSED	50 SHOPS
D	PARKING STATEMENT	
	CAR PARKING REQUIRED	
	SCOOTER PARKING REQUIRED	

APPROVED DETAILS

CIDCO/VVSR/NAP/BP-3519/2402. DATED- 25/02/2004.
CIDCO/VVSR/BP-3519/W/2617. DATED - 02/12/2005.
CIDCO/VVSR/BP-3519/LAYOUT/W/151. DATED - 29/01/2008.
CIDCO/VVSR/RDP/BP-3519/W/4122. DATED - 15/06/2009.
CIDCO/VVSR/RDP/BP-3519/W/5067. DATED - 08/10/2009.
CIDCO/VVSR/RDP/BP-3519/W/895. DATED - 07/07/2010.
VVCMC/TP/AM/VP-0453/BP-3519/010/2011-12 DATED 10-05-2011.
VVCMC/TP/AM/VP-0453/064/2011-12 DATED 13-09-2011.
VVCMC/TP/AM/VP-0453/296/2011-12 DATED 31-03-2012.
VVCMC/TP/AM/VP-0453/296/2011-12 DATED 13-06-2012.
VVCMC/TP/AM/VP-0453/296/2011-12 DATED 13-06-2012.
VVCMC/TP/AM/VP-0453/296/2012-13 DATED 28-10-2013.

NOTE:
* ONLY WRITTEN DIMENSIONS ARE TO BE FOLLOWED.
* INFRASTRUCTURE DETAILS SHOWN ON LAYOUT IS SCHEMETIC.
* ALL DIMENSIONS ARE IN METRIC SYSTEMS.

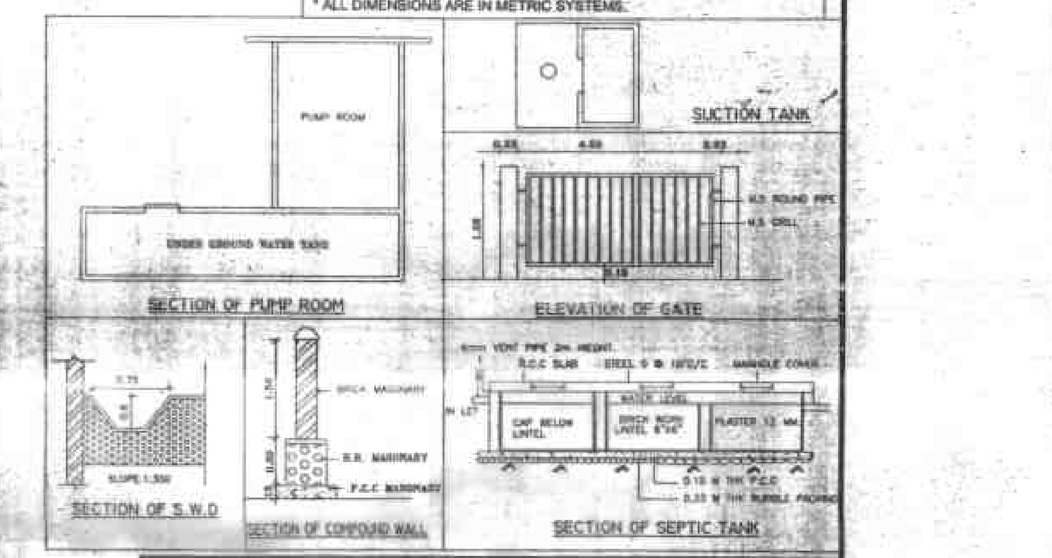

LEGEND :-

STATUS FOR BUILDING OF AVENUE - J,M,G &H.

INDICATES BUILDINGS FOR WHICH PLINTH COMPLITION CERTIFICATE IS RECEIVED - 86 WINGS

INDICATES BUILDINGS FOR WHICH APPLICATION MADE TO ISSUE P.C.C. - 2 WINGS

INDICATES BUILDINGS FOR WHICH PILING WORK OF PLINTH IS COMPLETED - 54 WINGS

AREA SUMMARY (RESERVATIONS) (EARLIAR APPROVED)

PROPOSED SCHOOL AREA	=	4575.38 SQM.
PROPOSED CLUBHOUSE AREA	=	8677.90 SQM.
PROPOSED MARKET AREA	=	5847.82 SQM.
PROPOSED CLUBHOUSE AREA	=	8635.15 SQM.
PROPOSED PRAYER HALL	=	128.53 SQM.
PROPOSED C.F.C.6 (COMM.)	=	564.82 SQM.

D.P. RESERVATIONS

Nos.	RESERVATIONS	AREA AS PER SANCTIONED PLAN	RE-LOCATED AREA
1	M (216)	2629.00	2629.00
2	HS (213)	12916.00	12926.00
3	HS (210)	13377.00	13377.00
4	PS (209)	4748.00	4748.00
5	PS (214)	7427.00	7427.00
6	PG (212)	26303.00	26303.00
7	G (215)	8147.00	8147.00
8	CC (201)	5780.00	6493.04
9	M (211)	3247.00	3247.00
10	HS (197)(PART)	221.31	221.31
11	M (208)(PART)	653.52	653.52
	TOTAL	85448.83	86171.87

R. G. AREA STATEMENT

RG.No	AREA IN SQMT.	RG.No	AREA IN SQMT.
1	1232.00	18	1792.00
2	448.00	19	1654.00
3	1135.00	20	1193.00
4	505.00	21	1580.00
5	465.00	22	871.00
6	925.00	23	871.00
7	877.00	25	17747.00
8	834.00	29	1280.00
9	1415.00	30	2575.00
9A	1300.00	31	890.00
9B	1300.00	34	298.00
10	1300.00	35	387.00
11	475.00	36	395.00
11A	239.52	39	710.00
12	1605.00	42	435.00
13	900.00	44	309.00
14	1135.00	45	235.00
15	1480.00	46	397.00
16A	270.00		
16B	150.00		
16C	130.00		
TOTAL			101411.00

NOTE:-
D.P. ROAD AREA CALCULATIONS IS AS PER 20.00 MTS WIDTH HOWEVER ACTUAL ROAD AT SITE IS 24.00 MTS.

FORM II

CONTENTS OF SHEET

LAYOUT PLAN,C.F.C., R.G., BUILT UP AREA,PARKING AREA STATEMENTS ETC.

STAMP OF APPROVAL OF PLANS

Approved as amended in subject to the conditions mentioned in this office letter No. VVCMC / T.P./ AMEND / BP - 3915 / W - 0453 / 677 / 2014-15 DATE - 03/07/2014

Deputy Director Town Planning, Vasai-Virar City Municipal Corporation, Virar (E)

AS BUILT DRAWINGS APPROVED SUBJECT TO CONDITIONS MENTIONED IN This Office Inwards ... BP... Dated ...

THIS PLAN SHALL NOT BE CONSIDERED AS A PROOF OF OWNERSHIP ... DISPUTES IN ANY COURT OF LAW

THIS PLAN SHALL NOT BE CONSIDERED AS A PROOF OF OWNERSHIP FOR ANY DISPUTES IN ANY COURT OF LAW

The amended plan duly approved herewith supercedes all the earlier approved plans

I hereby certify that the structural work of the above proposal will be carried out as per structural design and details considering seismic load Zone

DESCRIPTION OF PROPOSAL AND PROPERTY

PROPOSED RESIDENTIAL, COMMERCIAL,INSTITUTIONAL,CLUB HOUSE, AMUSEMENT PARK & INFORMATION TECHNOLOGY ESTABLISHMENT BUILDINGS AT GROUP HOUSING SCHEME ON NEW SURVEY NO.6,92,97,56,30 AT VILL. DONGRE ,VIRAR (W) ,TAL. VASAI ,DIST. THANE.

NAME OF OWNER

M/S. EVERSHINE DEVELOPERS .

For Evershine Developers

DATE	JOB NO	DWG NO	SCALE	DRAWN BY	DIR.
30/06/2014			AS SHOWN	RETHEESH	AMD/01/2014

NORTH LINE

SIGNATURE, NAME AND ADDRESS OF ARCHITECT:-

SHAH GATTANI CONSULTANTS
ARCHITECTS & ENGINEERS
103, LUCKY PALACE, STATION ROAD VASAI (WEST)
TEL. NO. VASAI 0250 - 2350001 /02 /03. MUMBAI 2389 3698, 2389 2791

GLOBAL CITY-2012